
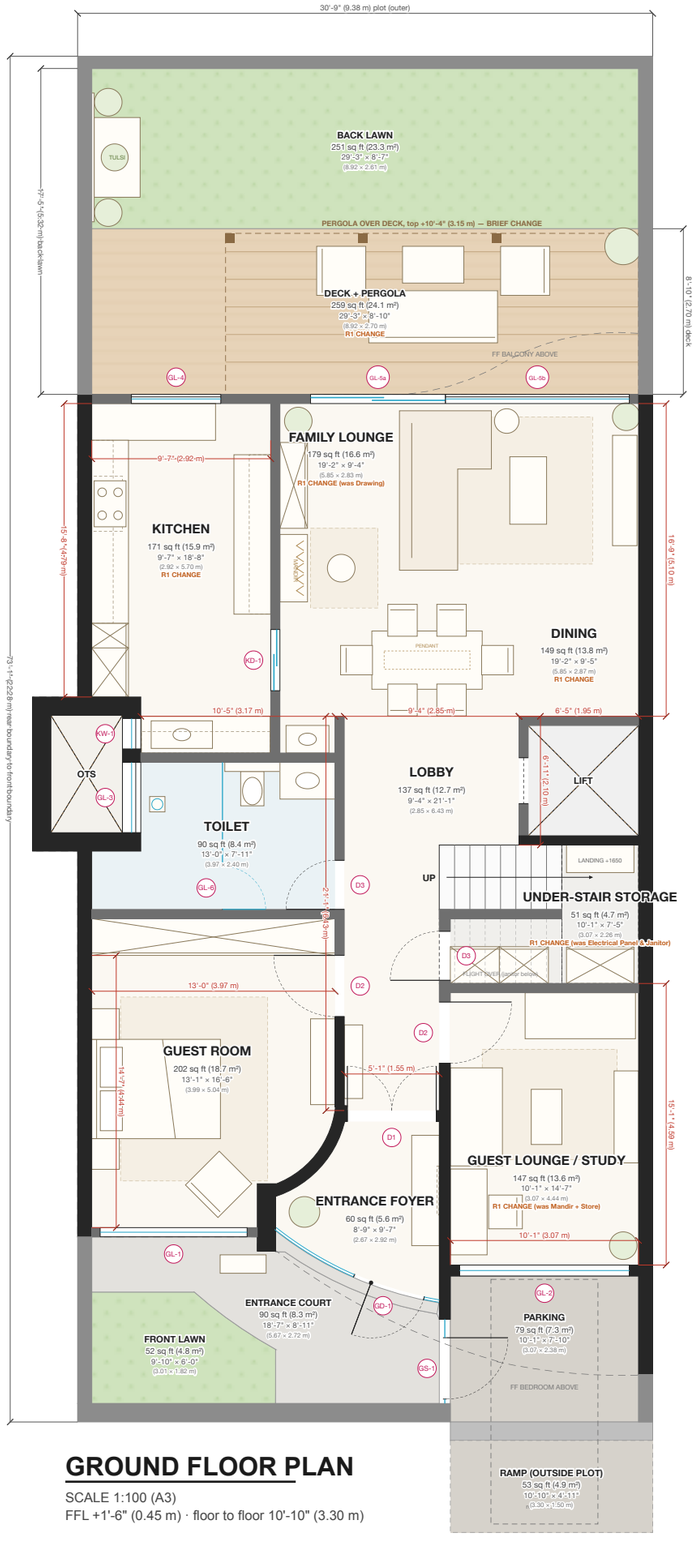


GROUND FLOOR PLAN

SCALE 1:100 (A3)
FFL +1'-6" (0.45 m) · floor to floor 10'-10" (3.30 m)

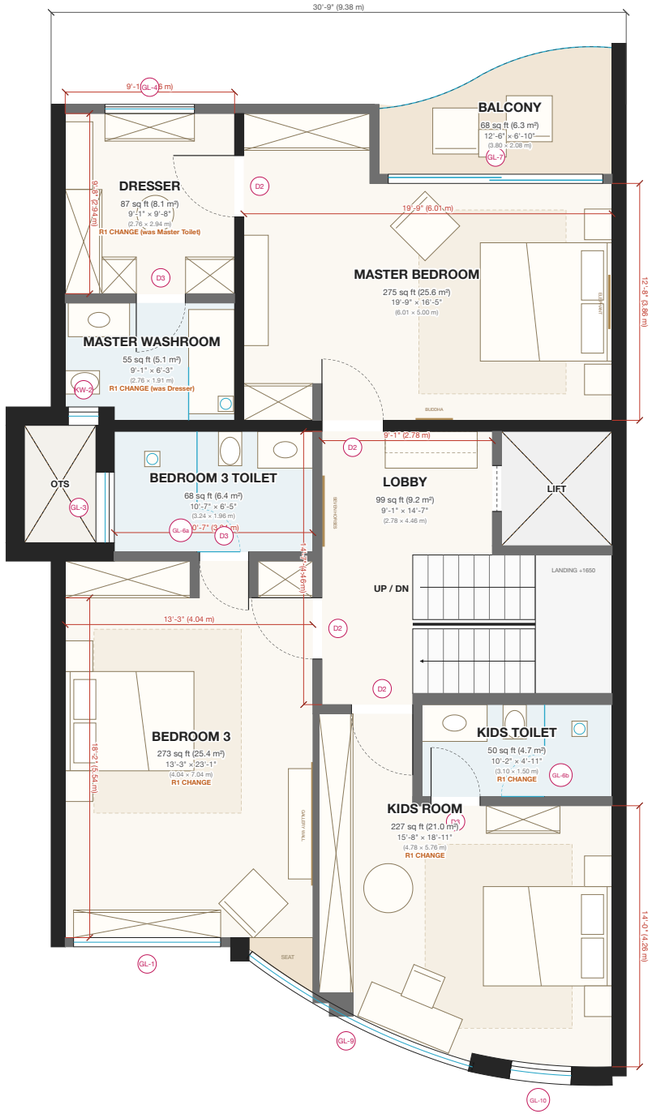

FIRST FLOOR PLAN

SCALE 1:100 (A3)
FFL +12'-4" (3.75 m) · floor to floor 10'-10" (3.30 m)

LEGEND

- Existing wall
- Proposed wall (SF)
- Glass / glazing
- D2 — Door / window mark (see schedule)
- New wall / partition
- Boundary wall 1500 high
- Floor above / overhead (dashed)
- **R1 CHANGE** room changed from R0

N
road side

REVISIONS

REV	DATE	DESCRIPTION
R0	17.08.25	Ground floor plan issued for approval (UPS).
R1	26.10.26	Owner changes of Oct 2026 on R0: layout, Vastu red-lines, plumbing, electrical and materials. FF and proposed SF added. See sheet 2.

GRAPHIC SCALE 1:100

0 — 5 m
0 — 16 ft

DOOR-WINDOW SCHEDULE

MARK	SIZE	CILL	LINTEL	NOS	DESCRIPTION	LOCATION	R1
GL-1	7'-10" × 7'-7" (2.40 × 2.30 m)	0'-4" (0.10 m)	7'-10" (2.40 m)	2	Glass Window Fixed/Openable	GF Guest Room; FF Bedroom 3	
GL-2	9'-1" × 7'-7" (2.77 × 2.30 m)	0'-4" (0.10 m)	7'-10" (2.40 m)	1	Glass Window Fixed/Openable	GF Guest Lounge / Study	
GL-3	3'-9" × 4'-9" (1.15 × 1.45 m)	3'-1" (0.95 m)	7'-10" (2.40 m)	2	Glass Window Openable	GF Toilet; FF Bedroom 3 Toilet	
GL-4	4'-9" × 4'-9" (1.46 × 1.45 m)	3'-1" (0.95 m)	7'-10" (2.40 m)	2	Glass Window Openable	GF Kitchen; FF Dresser	
GL-5a	7'-3" × 7'-10" (2.20 × 2.40 m)	—	7'-10" (2.40 m)	1	uPVC sliding door, one sash fixed; mesh; MS grille inside (replaces GL-5)	GF Family Lounge	new
GL-5b	9'-10" × 4'-11" (3.00 × 1.50 m)	2'-11" (0.90 m)	7'-10" (2.40 m)	1	uPVC window, fixed + sliding; mesh; MS grille outside (replaces GL-5)	GF Family Lounge	new
GL-6	As per site (6'-7" / 2.00 m high)	0'-4" (0.10 m)	—	4	Shower Partition with glass door	GF Toilet; FF Bedroom 3 Toilet, Kids Toilet, Master Washroom	
GL-7	11'-6" × 7'-7" (3.50 × 2.30 m)	0'-4" (0.10 m)	7'-10" (2.40 m)	1	Glass Door/Window Fixed/Openable	FF Master Bedroom	
GL-8	13'-0" × 3'-7" (3.98 × 1.10 m)	0'-4" (0.10 m)	—	1	Glass Railing	FF Balcony	
GL-9	13'-5" × 7'-7" (4.10 × 2.30 m)	0'-4" (0.10 m)	7'-10" (2.40 m)	1	Glass Window Fixed/Openable	FF Kids Room	
GL-10	3'-3" × 4'-9" (1.00 × 1.45 m)	3'-1" (0.95 m)	7'-10" (2.40 m)	1	Glass Window Openable	FF Kids Room	
GL-F	9'-8" arc (2.95 m) × full height	—	—	1	Curved frameless glass facade, floor to ceiling	GF Entrance Foyer	added
GD-1	3'-11" × 7'-10" (1.20 × 2.40 m)	—	7'-10" (2.40 m)	1	Frameless glass pivot entry door (in GL-F)	GF Entrance Foyer	added
GS-1	3'-3" × 6'-11" (1.00 × 2.10 m)	—	6'-11" (2.10 m)	1	Glass screen with 1000 gate	GF Parking / Entrance Court	added
KD-1	3'-3" × 7'-10" (1.00 × 2.40 m)	—	7'-10" (2.40 m)	1	Sliding door, fluted glass in black frame	GF Dining / Kitchen	new
KW-1	1'-8" × 2'-0" (0.50 × 0.60 m)	3'-5" (1.05 m)	5'-5" (1.65 m)	1	Vent window with exhaust fan, into OTS	GF Kitchen	new
KW-2	1'-8" × 2'-0" (0.50 × 0.60 m)	4'-11" (1.50 m)	6'-11" (2.10 m)	1	Vent window with exhaust fan, into OTS	FF Master Washroom	new
D1	4'-9" × 7'-10" (1.45 × 2.40 m)	—	7'-10" (2.40 m)	1	Flush Door, double leaf (main door)	GF Entrance Foyer	
D2	3'-3" × 7'-10" (1.00 × 2.40 m)	—	7'-10" (2.40 m)	6	Flush Door	GF Guest Lounge / Study, Guest Room; FF Bedroom 3, Kids Room, Master Bedroom, Master Bedroom / Dresser	
D3	2'-7" × 7'-10" (0.80 × 2.40 m)	—	7'-10" (2.40 m)	5	Flush Door	GF Toilet, Under-stair Storage; FF Bedroom 3 Toilet / Bedroom 3, Dresser / Master Washroom, Kids Toilet / Kids Room	
D4	As Lift	—	—	2	As Lift, as per lift vendor	GF Lift / Lobby; FF Lift / Lobby	

Sizes W × H in feet-inches (metres). CILL and LINTEL above finished floor. NOS = number on this sheet. new = not on R0; added = drawn on R0, not scheduled. ± = more than one size, as marked on plan.

FINISHING SCHEDULE

LOCATION	FLOOR	WALL	CEILING	REMARKS	R1
GF Parking & Ramp	Cobble Stone	Granite Stone	—		
GF Entrance Court	Granite Stone (flamed)	Paint Finish	Paint Finish		
GF Entrance Foyer	Italian Stone*	Veneer Cladding; fluted veneer feature wall	POP Painted / Veneer, cove light		△
GF Lobby	Italian Stone*	Veneer Cladding	POP Painted, cove light		△
GF Guest Lounge / Study	Italian Stone*	Veneer Cladding	POP Painted, cove light	was Mandir + Store. Desk, sofa, settee, TV (B5)	△
GF Guest Room	Italian Stone*	Paint Finish	POP Painted, cove light	Wardrobe on S wall	
GF Toilet	Tile (matte 1200×600)	Tile	POP Painted		
GF Family Lounge	Italian Stone*	Paint Finish; fluted veneer feature wall	POP Painted, cove light	was Drawing. TV + AC on W wall; open mandir in NE corner (B3, B6)	△
GF Dining	Italian Stone*	Paint Finish	POP Painted, cove light + veneer raft	Dining beside the lobby; hand-wash basin niche (D-01, B3)	△
GF Kitchen	Italian Stone*	Paint Finish; Italian Stone backsplash	POP Painted, cove light	Closed U-kitchen + wash nook; counter top black granite 20 mm (D-01, B4)	△
GF Under-stair Storage	Granite Stone (flamed)	Paint Finish	Stair soffit, painted	was Electrical Panel & Janitor. Cupboards to stair soffit; inverter / network rack (B7)	+
GF Deck + Pergola	Deck tile (wood-look, anti-skid)	Paint Finish	Pergola, open	Deck + pergola; tulsi in lawn NE corner (B15)	△
FF Master Washroom	Tile (matte 1200×600)	Tile	POP Painted	was Dresser. Tub + over-tub screen; WC on OTS stack; sunken floor (hold) (C10)	+
FF Dresser	Italian Stone*	Paint Finish	POP Painted, cove light	was Master Toilet. Walk-in dresser lit by GL-4; mirror on E wall (C10)	+
FF Master Bedroom	Italian Stone*	Paint Finish; fluted veneer feature wall	POP Painted, cove light		+
FF Balcony	Deck tile (wood-look, anti-skid)	Paint Finish	—		+
FF Bedroom 3 Toilet	Tile (matte 1200×600)	Tile	POP Painted		+
FF Lobby	Italian Stone*	Paint Finish	POP Painted, cove light	Pantry counter by lift, black granite top (C8)	+
FF Bedroom 3	Italian Stone*	Paint Finish	POP Painted, cove light	Front-left bedroom (D-04)	+
FF Kids Room	Italian Stone*	Paint Finish	POP Painted, cove light	Study desk along GL-9 (C9, D-04)	+
FF Kids Toilet	Tile (matte 1200×600)	Tile	POP Painted	Back at its R0 place, stack SS-3 (C9)	+

* Italian Stone: Option A Italian marble 18 mm polished in place, or Option B large-format vitrified 1600 × 800 marble look. Owner to decide (materials schedule F16).
Tile: matte porcelain 1200 × 600, floors and walls of wet rooms. △ = changed from R0; + = row added in R1 (R0 schedules the GF only).

CONTRACTOR:-
UNIQUE PROJECT SOLUTIONS
D-53/4, Ground Floor, Shaheen Bagh, Abul Fazal Encl.-2
Jamia Nagar, Okhla, New Delhi 110025
E- uniqueprojectsolutions@gmail.com
M-9911012341

PROJECT :- RENOVATION WORK AT GH-18, CELEBRITY HOMES, PALAM VIHAR GURUGRAM

CLIENT:- **Mr. Praveen Kumar Yadav**

ARCHITECTS:-**Mr. Harish**

SHEET CONTENTS :-
GROUND FLOOR PLAN & FIRST FLOOR PLAN


DRN. | CHD. | DWG. NO. :- **UPS/GH18/PV/001**

RELEASED FOR :- ☐ PRELIMINARY ☐ TENDER ☐ INFORMATION ■ APPROVAL ☐ FABRICATION ☐ SERVE

DATE :- **26.10.26**

SCALE:- **1:100 (A3)**

REV. **R1** | SHT.NO. **1 of 2**

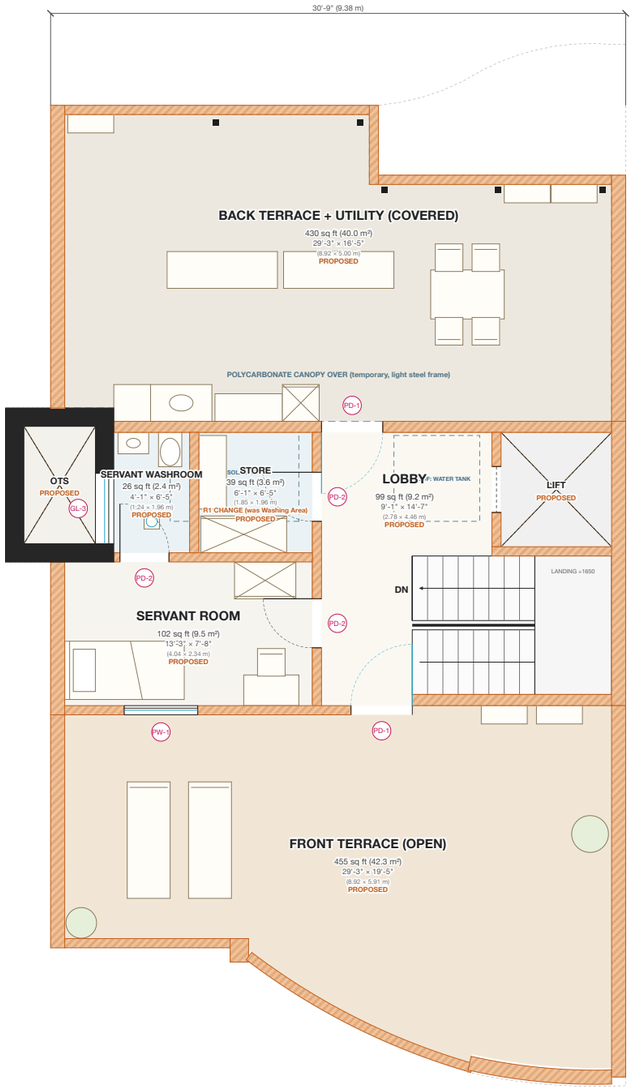

SECOND FLOOR PLAN (PROPOSED)

SCALE 1:100 (A3)
FFL +23'-2" (7.05 m) · floor to floor 10'-10" (3.30 m)

LEGEND

- Existing wall
- Proposed wall (SF)
- Glass / glazing
- Door / window mark (see schedule)
- New wall / partition
- Boundary wall 1500 high
- Floor above / overhead (dashed)
- R1 CHANGE room changed from R0

N
road side

GRAPHIC SCALE 1:100
0 5 m
0 16 ft

DOOR-WINDOW SCHEDULE · SF

MARK	SIZE	CILL	LINTEL	NOS	DESCRIPTION	LOCATION
GL-3	3'-9" × 4'-9" (1.15 × 1.45 m)	3'-1" (0.95 m)	7'-10" (2.40 m)	1	Glass Window Openable	SF Servant Washroom
PD-1	3'-3" × 7'-10" (1.00 × 2.40 m)	—	7'-10" (2.40 m)	2	Glazed door to terrace	SF Back Terrace + Utility (covered), Front Terrace (open)
PW-1	3'-11" × 4'-9" (1.20 × 1.45 m)	3'-1" (0.95 m)	7'-10" (2.40 m)	1	Glass Window Openable	SF Servant Room
PD-2	2'-7" × 7'-10" (0.80 × 2.40 m)	—	7'-10" (2.40 m)	3	Flush Door	SF Servant Room, Servant Washroom / Servant Room, Store
D4	As Lift	—	—	1	As Lift, as per lift vendor	SF Lift / Lobby

R1 REVISION NOTES (CHANGES FROM R0)

REF	AREA	CHANGE
A1, A2	General	North is the road side (all consultant drawings). Dimensions in feet-inches with metres in brackets.
B3	GF Family Lounge	Drawing room becomes a family lounge: TV and AC on the west wall, L-sofa facing the TV.
B6	GF Family Lounge	Small open mandir on the east wall at the NE corner; devotee faces east; no toilet behind or above.
D-01	GF Kitchen / Dining	Closed kitchen on the R0 peninsula line with sliding door KD-1; dining moved beside the lobby.
B4	GF Kitchen	No construction outside: GL-4 back at its R0 position; wash nook (double sink) inside, vent KW-1 into the OTS.
B5	GF Study	Becomes Guest Lounge / Study: desk on the east wall, sofa, settee, TV.
B7	GF Panel & Janitor	Becomes under-stair storage with inverter / network rack; DB-1 moves to the kitchen east wall (SE).
B15	GF Back lawn	Deck and pergola outside the lounge; tulsi vrindavan in the lawn's NE corner on the boundary wall.
F18	GF Family Lounge	All-glass GL-5 replaced: uPVC sliding door GL-5a (3'-5" clear) + window GL-5b on a 2'-11" sill; mesh, grilles; pergola +6".
C10	FF Master suite	Washroom and dresser swapped (bedroom → dresser → washroom); bath tub with over-tub screen; vent KW-2.
D-04, C9	FF Bedrooms	Front-left room is Bedroom 3, front-right is the Kids Room; kids toilet back at its R0 place.
C8	FF Lobby	Cupboard by the lift becomes a pantry counter with wall cupboards, 10" clear of the lift door.
D11	SF (proposed)	Lobby, servant room + washroom, store; open utility and drying on the covered back terrace.
E12, E13	Services	Plumbing and electrical layouts Rev A re-applied to this layout (separate drawings and reports).
F16	Materials	Floors: Italian marble (Option A) or 1600 × 800 tiles (Option B), owner to decide; counters black granite.

GENERAL NOTES

NO	NOTE
1	All dimensions in feet-inches with metres in brackets. Do not scale; check on site.
2	Drawn from the R1 model (house_r1.json). Every R0 dimension is re-measured (plans/r1/check_report.txt).
3	The second floor is a proposal; it is not on R0. Structure, lift overrun and tank stand to be confirmed.
4	Read with the R1 change register, the plumbing and electrical reports and the materials schedule.

FINISHING SCHEDULE · SF

LOCATION	FLOOR	WALL	CEILING	REMARKS
SF Lobby	Italian Stone*	Paint Finish	POP Painted	
SF Servant Washroom	Tile (matte 1200×600)	Tile	POP Painted	
SF Store	Tile (matte 1200×600)	Tile	POP Painted	was Washing Area. Linen / utility store (D11)
SF Servant Room	Vitrified tile 600×600	Paint Finish	POP Painted	
SF Back Terrace + Utility (covered)	Deck tile (wood-look, anti-skid)	Paint Finish	Polycarbonate canopy	Washer-dryer, sink, ironing, drying racks (D11)
SF Front Terrace (open)	Deck tile (wood-look, anti-skid)	Paint Finish (parapet)	— (open)	

OPEN ITEMS & HOLD POINTS

ITEM	FOR
Master washroom over the kitchen: sunken floor, waterproofing, flood test	Architect, structural, plumber
Front curved balcony (red-line 16): kids-room glazing forms the curve	Architect
GF toilet vanity at the south end (R0 position kept)	Architect
Tank stand on the SF roof, OTS opening, lift pit and overrun	Structural, lift vendor
Deck pergola under "no outside construction"	Owner
Deck to lawn: 1'-0" (0.30 m) drop without a step; rear door GL-5a on the south wall	Architect, Vastu consultant
Living / bedroom floors: Option A marble or Option B tiles	Owner
Tulsi in the plot's SE zone; guest-room AC unit in the NE; DB-3 in the E zone	Vastu consultant
Master headboard on the W wall (red-line asks S); SF rooms not in the S / SW	Vastu consultant
Sewer invert levels and the municipal connection	Plumber, RWA / MCG

ROOM AREAS (internal, incl. built-in joinery)

FLR	ROOM	SQ FT	M²
GF	Kitchen	171	15.9
GF	Dining	149	13.8
GF	Family Lounge	179	16.6
GF	Lobby	137	12.7
GF	Toilet	90	8.4
GF	Guest Room	202	18.7
GF	Entrance Foyer	60	5.6
GF	Guest Lounge / Study	147	13.6
GF	Under-stair Storage	51	4.7
GF	Total indoor	1185	110.1
FF	Master Washroom	55	5.1
FF	Dresser	87	8.1
FF	Master Bedroom	275	25.6
FF	Balcony (outdoor)	68	6.3
FF	Bedroom 3 Toilet	68	6.4
FF	Lobby	99	9.2
FF	Bedroom 3	273	25.4
FF	Kids Room	227	21.0
FF	Kids Toilet	50	4.7
FF	Total indoor	1135	105.5
SF	Lobby	99	9.2
SF	Servant Washroom	26	2.4
SF	Store	39	3.6
SF	Servant Room	102	9.5
SF	Back Terrace + Utility (covered) (outdoor)	430	40.0
SF	Front Terrace (open) (outdoor)	455	42.3
SF	Total indoor	266	24.7

CONTRACTOR:-
UNIQUE PROJECT SOLUTIONS
D-53/4, Ground Floor, Shaheen Bagh, Abul Fazal Encl.-2
Jamia Nagar, Okhla, New Delhi 110025
E- uniqueprojectsolutions@gmail.com
M-9911012341

PROJECT :- RENOVATION WORK AT GH-18, CELEBRITY HOMES, PALAM VIHAR GURUGRAM
CLIENT:- **Mr. Praveen Kumar Yadav**
ARCHITECTS:-**Mr. Harish**

SHEET CONTENTS :-
SECOND FLOOR PLAN (PROPOSED) & R1 NOTES

DRN. | CHD. | DWG. NO. :- **UPS/GH18/PV/001**

RELEASED FOR :- ☐ PRELIMINARY ☐ TENDER ☐ INFORMATION ■ APPROVAL ☐ FABRICATION ☐ SERVE

DATE :- **26.10.26**
SCALE:- **1:100 (A3)**
REV. **R1** | SHT.NO. **2 of 2**